उडुपि UDUPI
स्टेशन संचालन नियम आरेख
STATION WORKING RULE DIAGRAM

वर्ग - ख , मानक - ~~II(आर)~~ III(आर)
CLASS - B , STANDARD - ~~II(R)~~ III(R)

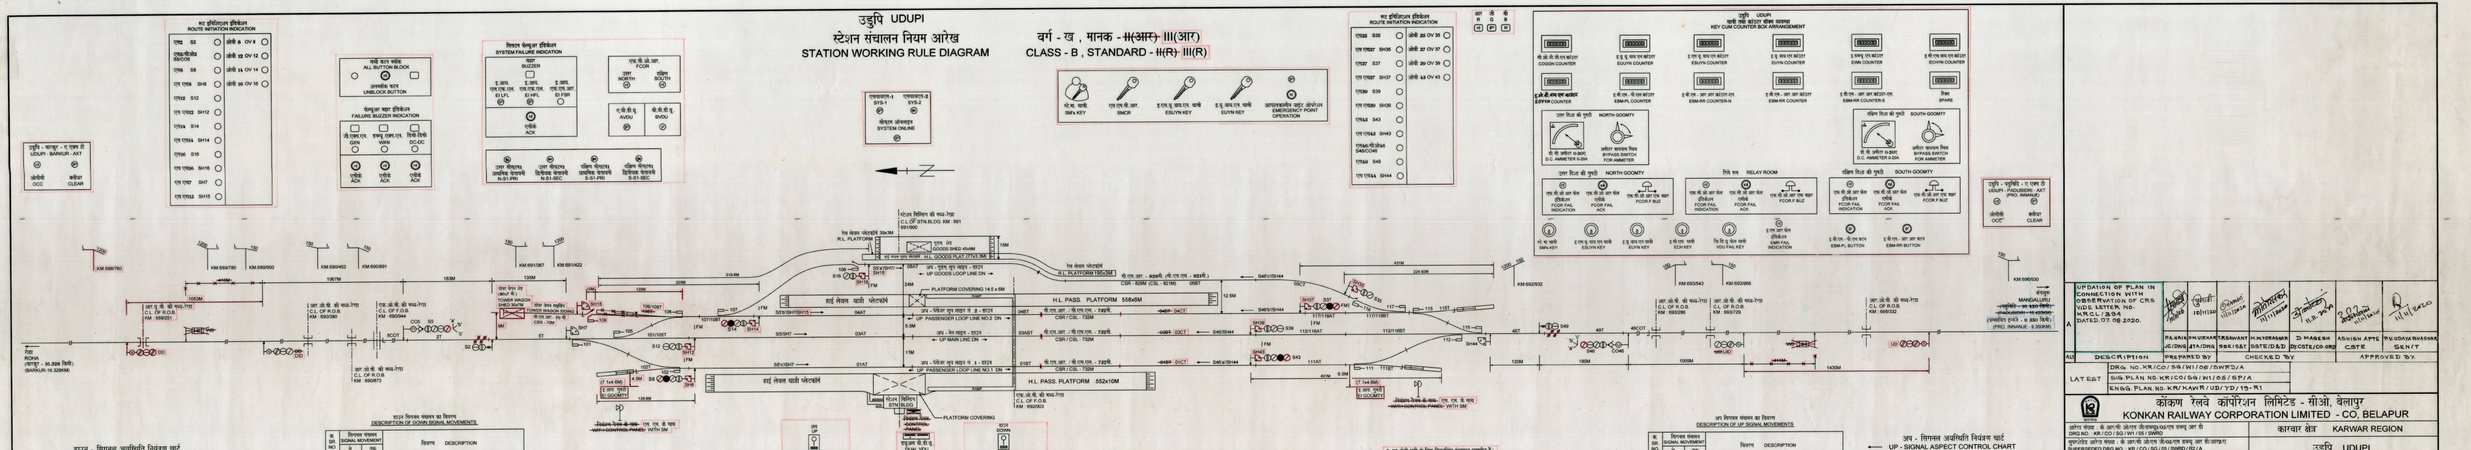

सं. SL NO.	विगमन संकेत SIGNAL MOVEMENT से FROM	तक TO	विवरण DESCRIPTION
1	S5	S43	DN HOME RECEPTION TO LOOP LINE NO.1
2	S5	S39	DN HOME RECEPTION TO MAIN LINE
3	S5	S37	DN HOME RECEPTION TO LOOP LINE NO.2
4	S5	S35	DN HOME RECEPTION TO GOODS LOOP LINE
5	CO5	S43	DN CALLING ON RECEPTION ON LOOP LINE NO.1
6	CO5	S39	DN CALLING ON RECEPTION ON MAIN LINE
7	CO5	S37	DN CALLING ON RECEPTION ON LOOP LINE NO.2
8	CO5	S35	DN CALLING ON RECEPTION ON GOODS LOOP LINE
9	SH7	SH43	DN SHUNTING TO LOOP LINE NO. 1
10	SH7	SH39	DN SHUNTING TO MAIN LINE
11	SH7	SH37	DN SHUNTING TO LOOP LINE NO. 2
12	SH7	SH35	DN SHUNTING TO GOODS LOOP LINE
13	SH15	SH37	DN SHUNTING TO LOOP LINE NO. 2
14	SH35	S49	DN SHUNTING TO S49
15	SH37	S49	DN SHUNTING TO S49
16	SH39	S49	DN SHUNTING TO S49
17	SH43	S49	DN SHUNTING TO S49
18	S35	S49	DN STARTER DISPATCH FROM GOODS LOOP LINE
19	S37	S49	DN STARTER DISPATCH FROM LOOP LINE NO.2
20	S39	S49	DN STARTER DISPATCH FROM MAIN LINE
21	S43	S49	DN STARTER DISPATCH FROM LOOP LINE NO.1
22	S49	DN DEP	DN ADVANCED STARTER DISPATCH TO PADUBIDRI-BARKUR (PRO. INNAUR)

सं. SL NO.	विगमन संकेत SIGNAL MOVEMENT से FROM	तक TO	विवरण DESCRIPTION
1	S46	S6	UP HOME RECEPTION TO LOOP LINE NO.1
2	S46	S12	UP HOME RECEPTION TO MAIN LINE
3	S46	S14	UP HOME RECEPTION TO LOOP LINE NO.2
4	S46	S16	UP HOME RECEPTION TO GOODS LOOP LINE
5	CO46	S6	UP CALLING ON RECEPTION ON LOOP LINE NO.1
6	CO46	S12	UP CALLING ON RECEPTION ON MAIN LINE
7	CO46	S14	UP CALLING ON RECEPTION ON LOOP LINE NO.2
8	CO46	S16	UP CALLING ON RECEPTION ON GOODS LOOP LINE
9	SH8	S2	UP SHUNTING TO S2
10	SH14	S2	UP SHUNTING TO S2
11	SH14	S2	UP SHUNTING TO S2
12	SH14	TH2	UP SHUNTING TO TOWER WAGON SIDING
13	SH16	S2	UP SHUNTING TO S2
14	SH44	S2	UP SHUNTING TO LOOP LINE NO. 1
15	SH44	S2	UP SHUNTING TO MAIN LINE
16	SH44	SH14	UP SHUNTING TO LOOP LINE NO. 2
17	SH44	S2	UP SHUNTING TO GOODS LOOP LINE
18	S16	S2	UP STARTER DISPATCH FROM GOODS LOOP LINE
19	S14	S2	UP STARTER DISPATCH FROM LOOP LINE NO.2
20	S12	S2	UP STARTER DISPATCH FROM MAIN LINE
21	S6	S2	UP STARTER DISPATCH FROM LOOP LINE NO.1
22	S2	UP DEP	UP ADVANCED STARTER DISPATCH TO BARKUR STATION

1. इस बोर्ड रनौ के लिए विगमनीय संकेतपर उपयोग है।
2. SIGNAL LINE INSTALLATIONS BUT TO 23 AC
4. केवल ट्रेन एन्ट्री के लिए अतिरिक्त संकेत - अप ही एक जो / डी - अ47
5. SANDED DEAD END AS PER DRG. NO. : RDSO/T-347
6. उडुपि - मुल्कि सेक्शन के लिए ब्लॉक पैनल - बार्कुर में इनपुट तथा एन एस एल आउट टेलिफोन लगाए जाने होंगे।
7. DADO MAKE PLATFORM SINGLE LINE TELEPHONE ELECTRICAL BLOCK INSTRUMENT IS PROVIDED IN SMS OFFICE FOR SECTION UDUPI-PADUBIDRI.
8. ए ए सेक्शन और बार्कुर-मंगलौर के बीच एक सिंगल लाइन ब्लॉक टेलिफोन सेक्शन उपलब्ध है।
9. TELEPHONE CONNECTION PROVIDED BETWEEN SMS OFFICE AND NON-INTERLOCKED BY-PASS LOOP AT NH-17 (PRO. INNAUR)
1. उडुपि स्टेशन सर्वाधिक व्यस्त है उडुपि - बार्कुर और उडुपि - मुल्कि(पादुबिद्री) इन्ट्रेन्स सिग्नल के लिए सी-ओपरेटिव रिलेट सेक्शन, उपलब्ध किए जाएँगे। सी. पी. ओ. के निरीक्षण के समय में अतिरिक्त एक सिग्नल के आगमन होने की सुविधा प्रदान करने के बाद ही उपयोग को लिए किया जाएगा।
2. A CO-OPERATIVE RESET BOXES ARE TO BE PROVIDED IN SMS OFFICE AT UDUPI STATION FOR UDUPI - BARKUR AND UDUPI - PADUBIDRI (PRO. INNAUR) SECTION
3. BLOCK PANEL ALONG WITH UPSM & DPSM (WITH HASSDAC) IS TO BE PROVIDED FOR UDUPI - BARKUR AND UDUPI - PADUBIDRI (PRO. INNAUR) SECTION
4. बार्कुर - मंगलौर सेक्शन के लिए एक सिंगल लाइन ब्लॉक टेलिफोन सेक्शन उपलब्ध है।
5. BLOCK PANEL ALONG WITH UPSM & DPSM (WITH HASSDAC) IS TO BE PROVIDED FOR UDUPI - BARKUR AND UDUPI - PADUBIDRI (PRO. INNAUR) SECTION
6. उडुपि - मुल्कि सेक्शन के लिए एक सिंगल लाइन ब्लॉक टेलिफोन सेक्शन उपलब्ध है।
7. TWO-LINE MAIN SINGLE LINE TELEPHONE ELECTRICAL BLOCK INSTRUMENT IS PROVIDED IN SMS OFFICE FOR SECTION UDUPI - PADUBIDRI.



	विवरण DESCRIPTION	तैयार PREPARED BY	जाँचकर्ता CHECKED BY	सत्यापित VERIFIED BY	अनुमोदित APPROVED BY
A	UPDATION OF PLAN IN CONNECTION WITH OBSERVATION OF CRS VIDE LETTER NO. M.R.CL/2.5.4 DATED.07.08.2020.	P.A.NAIK / JE/TW	P.K.VIDYAKAR / JE/TW	T.R.SAWANT / JE/TW	M.M.TORASKAR / SE/SIG
REF	DESCRIPTION	PREPARED BY	CHECKED BY	VERIFIED BY	APPROVED BY
	DRG. NO. KR/CO/SG/WI/06/SWRD/A	P.A.NAIK / JE/TW	P.K.VIDYAKAR / JE/TW	T.R.SAWANT / SE/SIG	M.M.TORASKAR / SE/SIG
LAT EST	SIG PLAN NO. KR/CO/SG/WI/06/SP/A	D. MAGESH / DY.CSTE/CO-ORD	ASHISH APTE / CSTE	R.REVANASIDDAPPA / CSTE	
	ENGG. PLAN NO. KR/Kapt/UD/YD/19-R1				

संदर्भ REFERENCE	विस्तार संकेत सामान्य नियम आरेख संख्या : डी आर सी ओएस सीएस एस एस सी/ओएस/सी डी आरेख संख्या एस सी/ओएस/सी डी आरेख सीएस एस सी/ओएस/सी डी	
	PREVIOUS STATION WORKING/RULE DIAGRAM NO.- KR / CO / SG / SWRD / ~~III~~ A / B	
	विस्तार विगमनीय संकेत संख्या : डी आर सी ओ एस सी/ओएस/सी/एस/सी, डी आर सी ओएस सीओएस सीएस, डी आरएस, डी आरसी ओएस सीओएस/सी	
	PREVIOUS SIG. PLAN NO. : KR / CO / CSTE / UD / DS / A / B / C / D / E / F / G , KR / CO / SG / DS / SP / A, B, KR / CO / SG / DS / SP / R1/A	
	~~सिंगल लाइन ब्लॉक टेलिफोन सेक्शन~~ : ~~एस एस एस - उडुपि - मुल्कि~~ / ~~एस एस एस - उडुपि - बार्कुर~~ / ~~डी आर सी ओएस सीएस एस एस - उडुपि - मुल्कि~~ / ~~डी आर सी ओएस सीएस एस एस - उडुपि - बार्कुर~~	
	PREVIOUS ENGG. PLAN NO. - UD / Y / 15-92 / A1, A2, A3, A4, A5, A6, KR / KAWAR / UD / YD / 19	

कोंकण रेलवे कॉर्पोरेशन लिमिटेड - मीओ, बेलापुर
KONKAN RAILWAY CORPORATION LIMITED - CO, BELAPUR

कारवार क्षेत्र KARWAR REGION

उडुपि UDUPI
स्टेशन संचालन नियम आरेख
STATION WORKING RULE DIAGRAM

P.A.NAIK / JE/TW	P.K.VIDYAKAR / JE/TW	T.R.SAWANT / SE/SIG	M.M.TORASKAR / SE/SIG	D. MAGESH / DY.CSTE (P&R)	ASHISH APTE / CSTE
					R. REVANASIDDAPPA / CSTE
					DY. CSTE